

\$5.00 fee
for permit

ISLAND COUNTY HEALTH DEPARTMENT Phone Orange 8-4008
POST OFFICE BOX 66, COUPEVILLE, WASHINGTON

86

APPLICATION FOR PERMIT TO CONSTRUCT A SEWAGE DISPOSAL SYSTEM

Applicant's name: Mabana Union Sunday School (Inc.)

Mailing address: Mrs. B.W. Robinson Phone: 387-4126

Location of construction site: Mabana

Street number _____ Distance to nearest cross road _____
south of Pine Bend Cross Road

Legal description: Lpt _____ Sec. 15 Twp. 36N Blk. _____ Rge. 3E Addition Highlands on Robinson

Type of use Church No. of bedrooms 1 No. of bathrooms 2

Lot width: _____ ft. Lot depth: _____ ft. 1 acre sq. ft.

Source of drinking water: Public supply _____ Private Well X

1. Dig a hole at least 4 feet deep in the disposal field area. After the hole is dug record the soil conditions at the following depths:
(record as sand, gravel, clay, packed sand, loam, etc.)

12 inches sand 24 inches sand 36 inches sand 48 inches sand

2. Furnish sketch on reverse side hereof, or attach plot plan of premises showing -
- a. Distances between property lines and sewage system.
 - b. Distance to any well, spring, creek or other body of water.
 - c. Show direction and approximate slope of lot.
 - d. Show the location and layout of the septic tank system.
 - e. List size of septic tank, inside length, inside width, water depth capacity in gallons.
 - f. Width, length and depth of drain lines, amount of gravel under tile, amount of gravel over tile, type of tile used.
 - g. Location of buildings and driveways, swimming pools, etc.

3. Percolation test made June Date 8-64 Result: 3 min per inch

I hereby state that the information above and on the reverse side hereof, or attached hereto is correct and true to the best of my knowledge. I understand that the permit must be obtained before any construction is begun, either on the building or the sewage disposal system, and a satisfactory inspection of system is required before the sewage disposal system may be back-filled, or put to use.

Signed: Mabana Union Sunday School Date: June 8, 1964
Owner Mrs. B.W. Robinson (Dept.)

Signed: A. W. Watkins Date: June 8, 1964
Contractor

Plan approved: 1336 Permit No. 1336 Receipt No. 2975 Date 6/12/64


Final inspection approved X Rejected _____ By: Jaw Date 7-15-64

Remarks:

750 gal. tank will be used only on Sundays and maybe 2 or 3 times a month on other occasions.

Tank:	Inside Length	Inside Width	Water Depth	Gallons Capacity	750	M.G. Unit
Field Drain:	Total Length	70	Width	3'	Depth	3'
				No. of lines	2	
Gravel:	Size:	2" Overtile 2" inches, Undertile 6 inches.				

165.8 ft. N. line

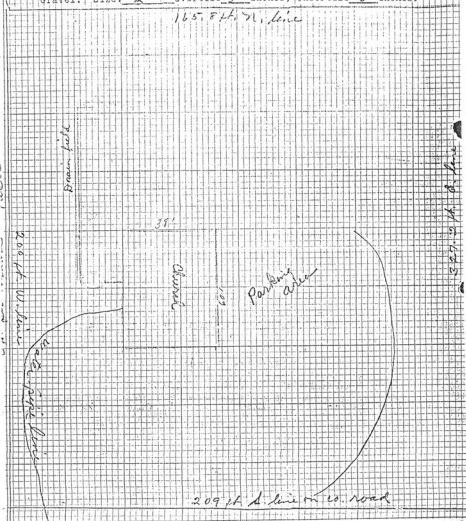

County Board